



FRONT ELEVATION

SCALE: 1/4" = 1'-0"

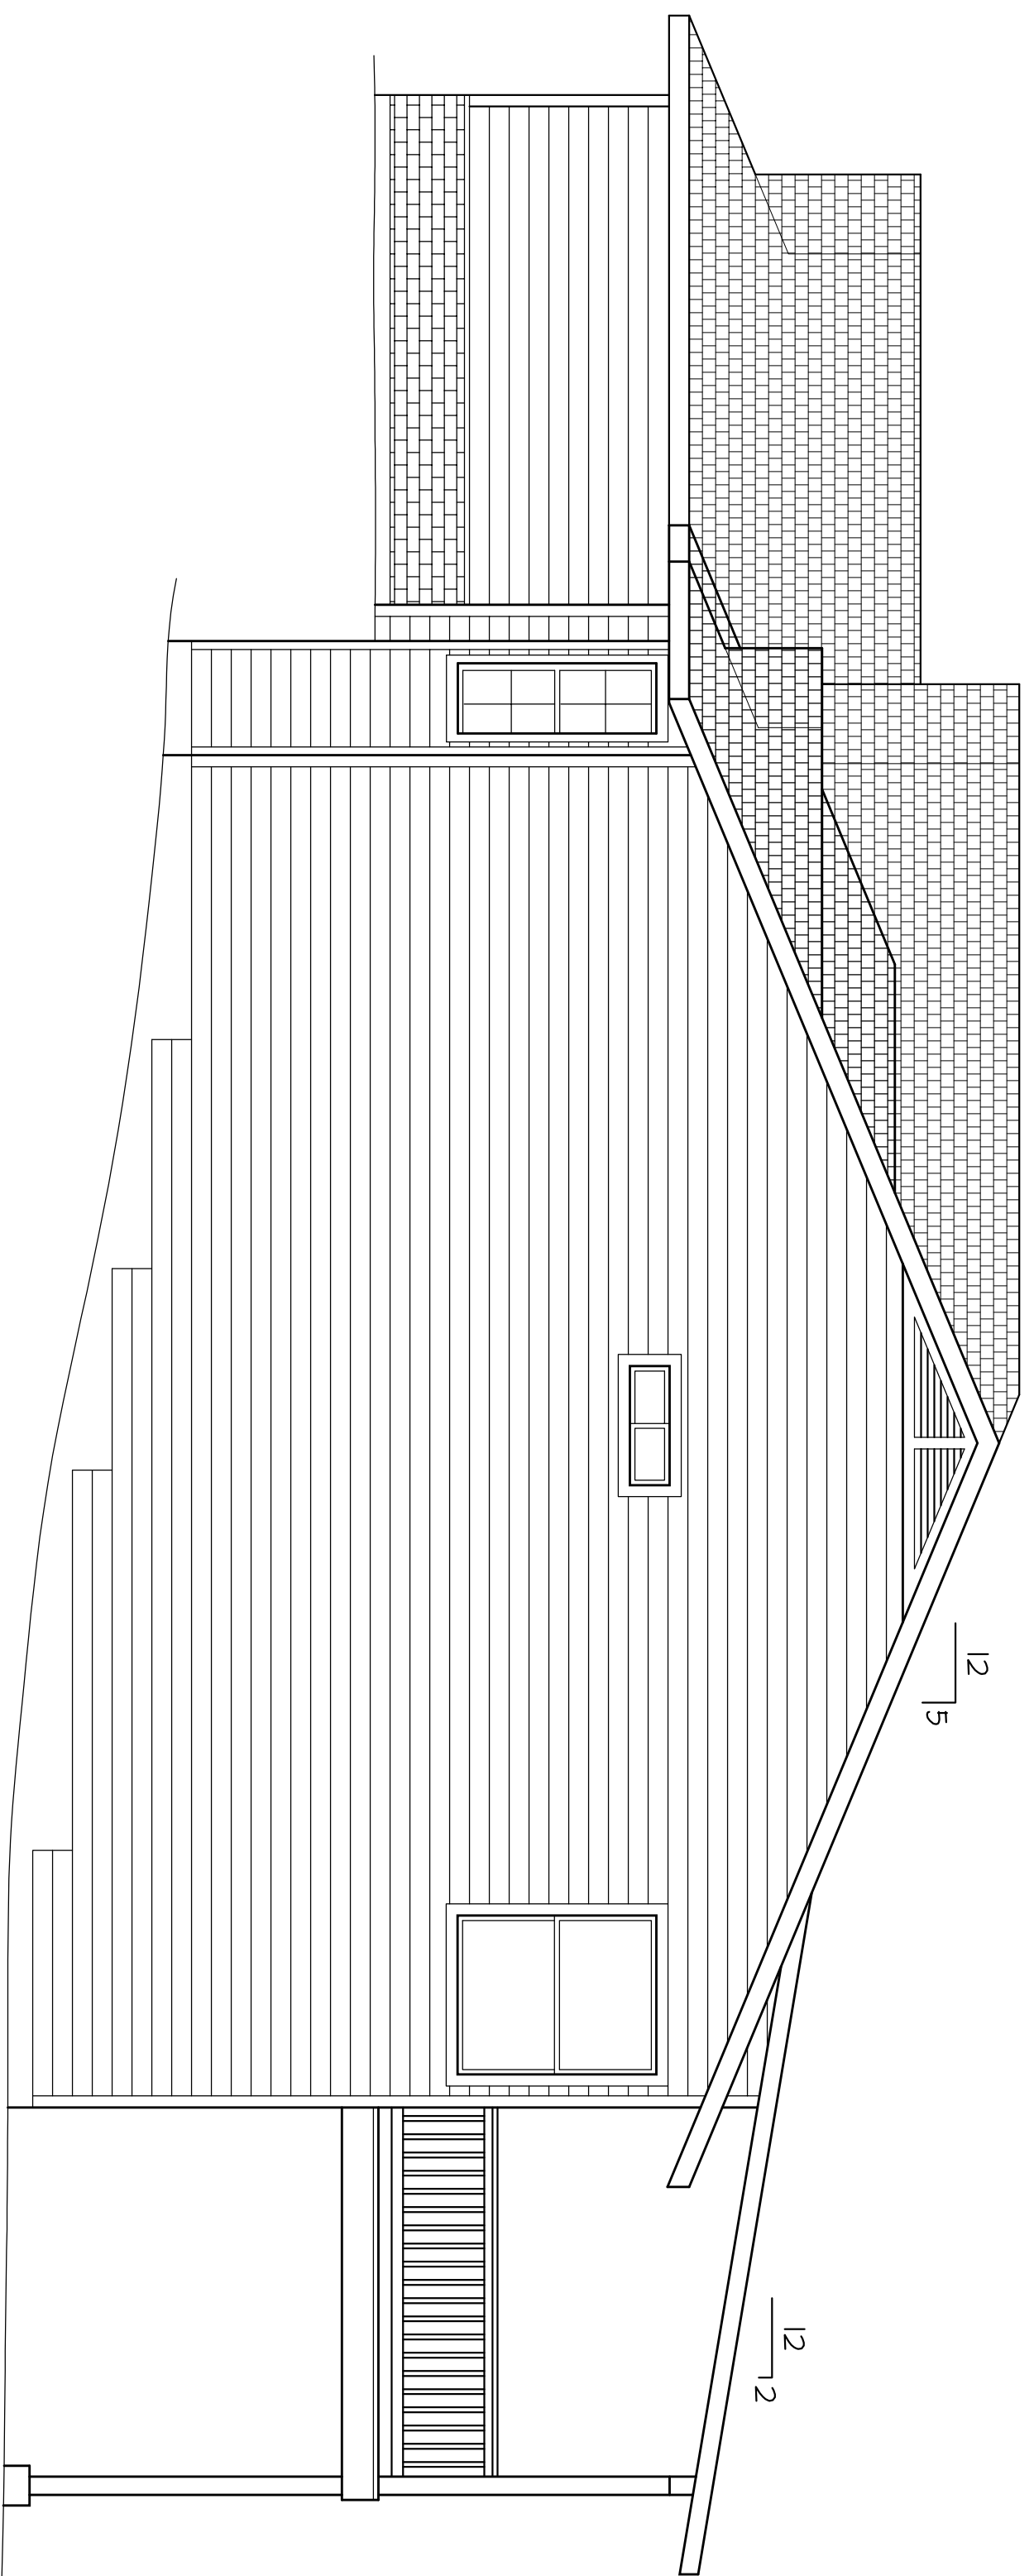


RIGHT - SIDE ELEVATION

SCALE: 1/4" = 1'-0"

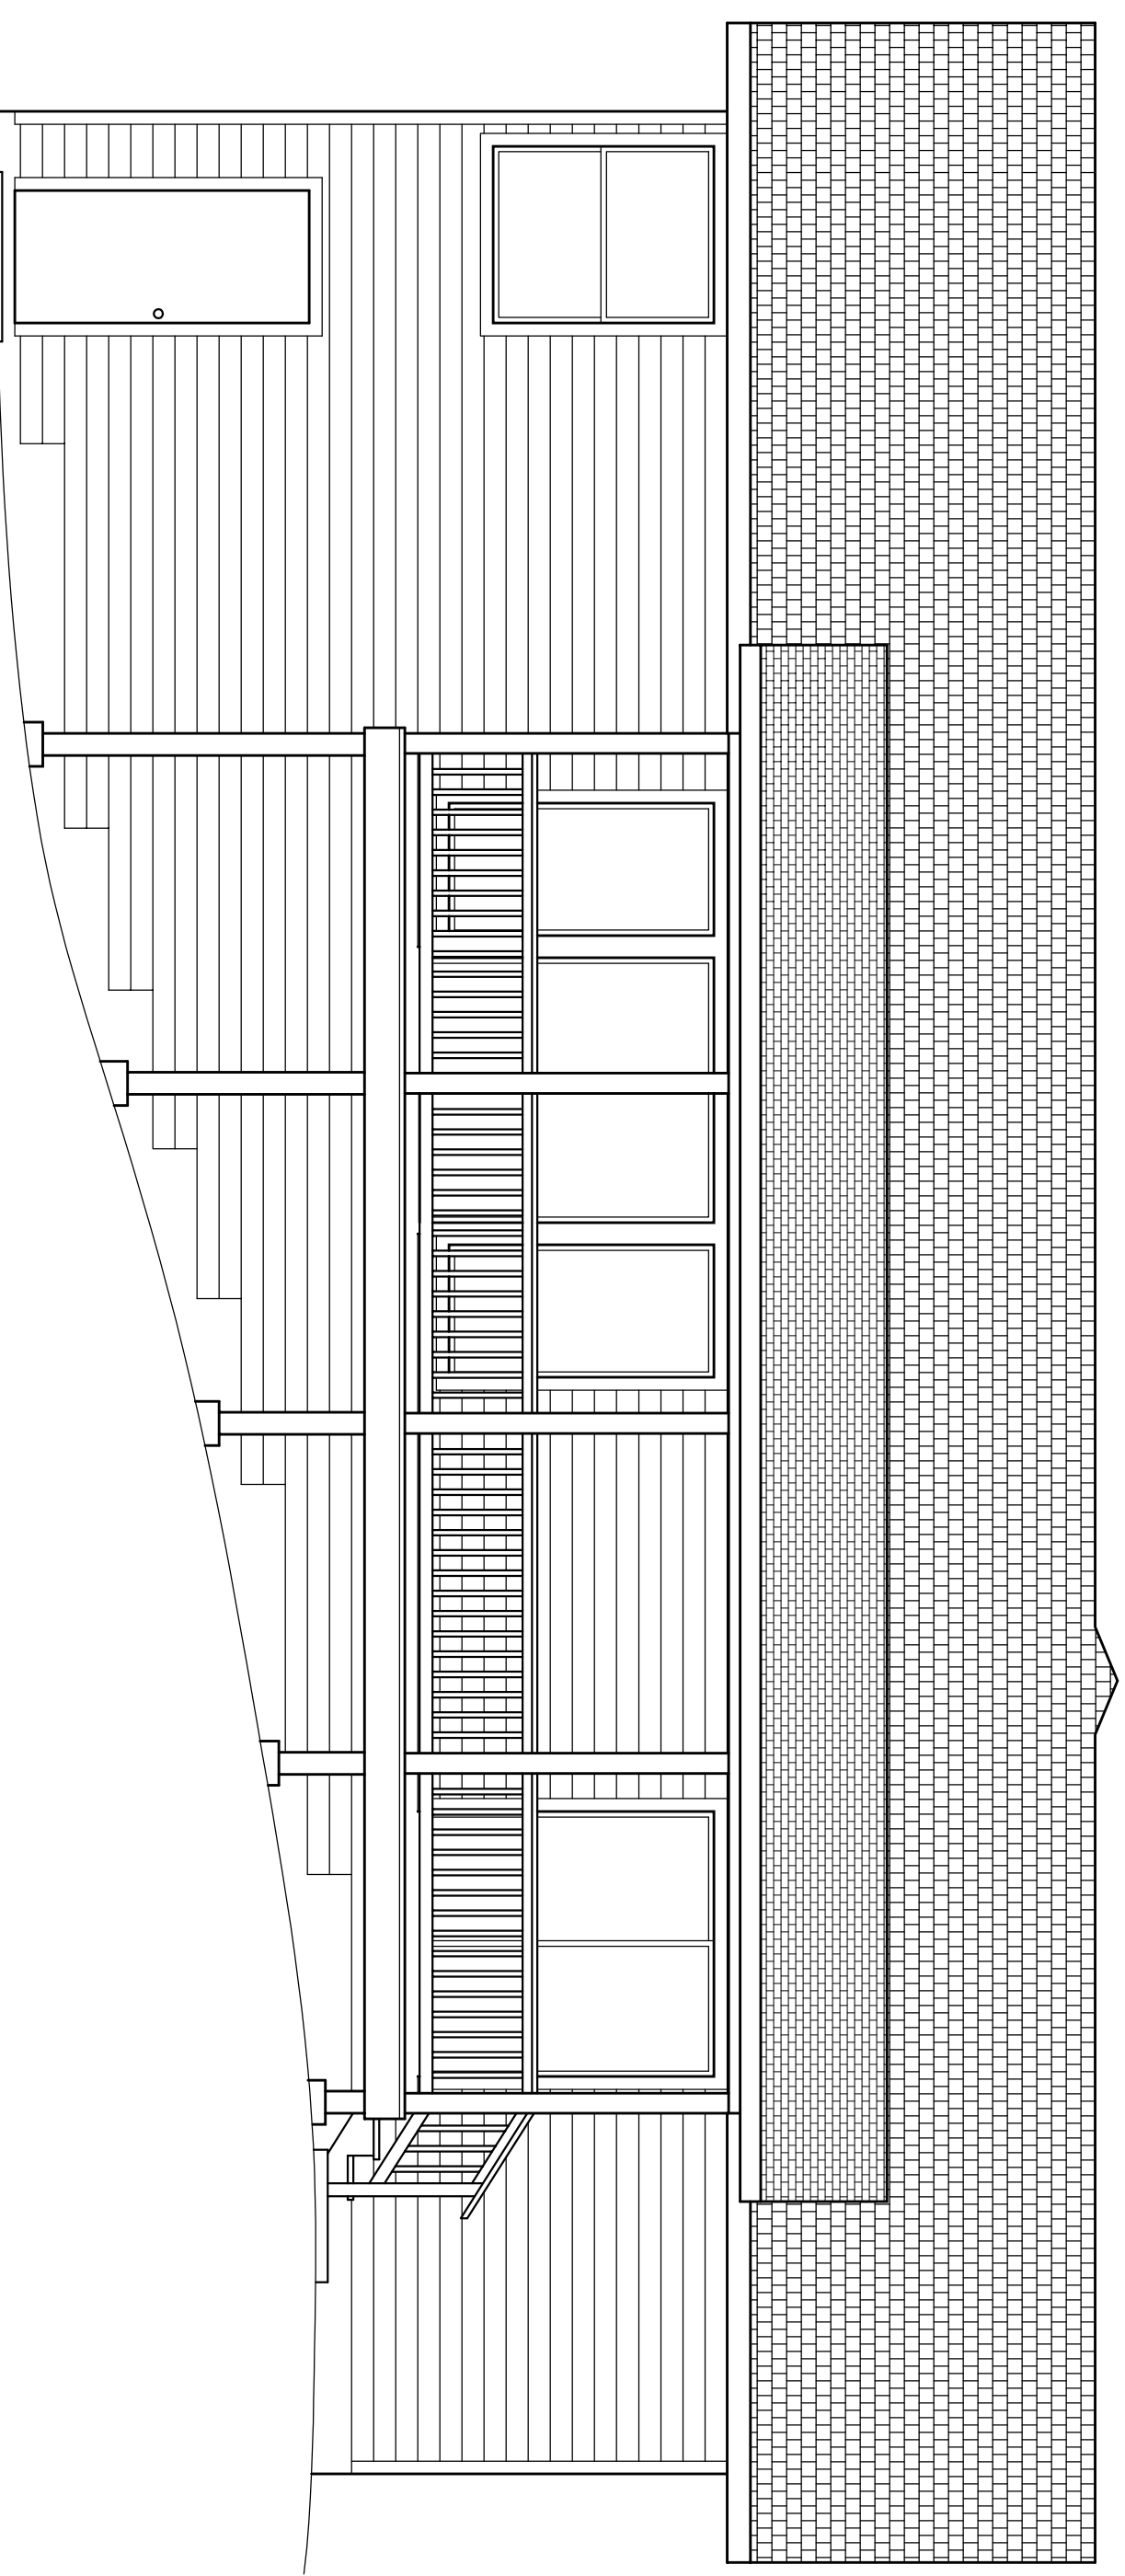

REAR ELEVATION

SCALE: 1/4" = 1'-0"

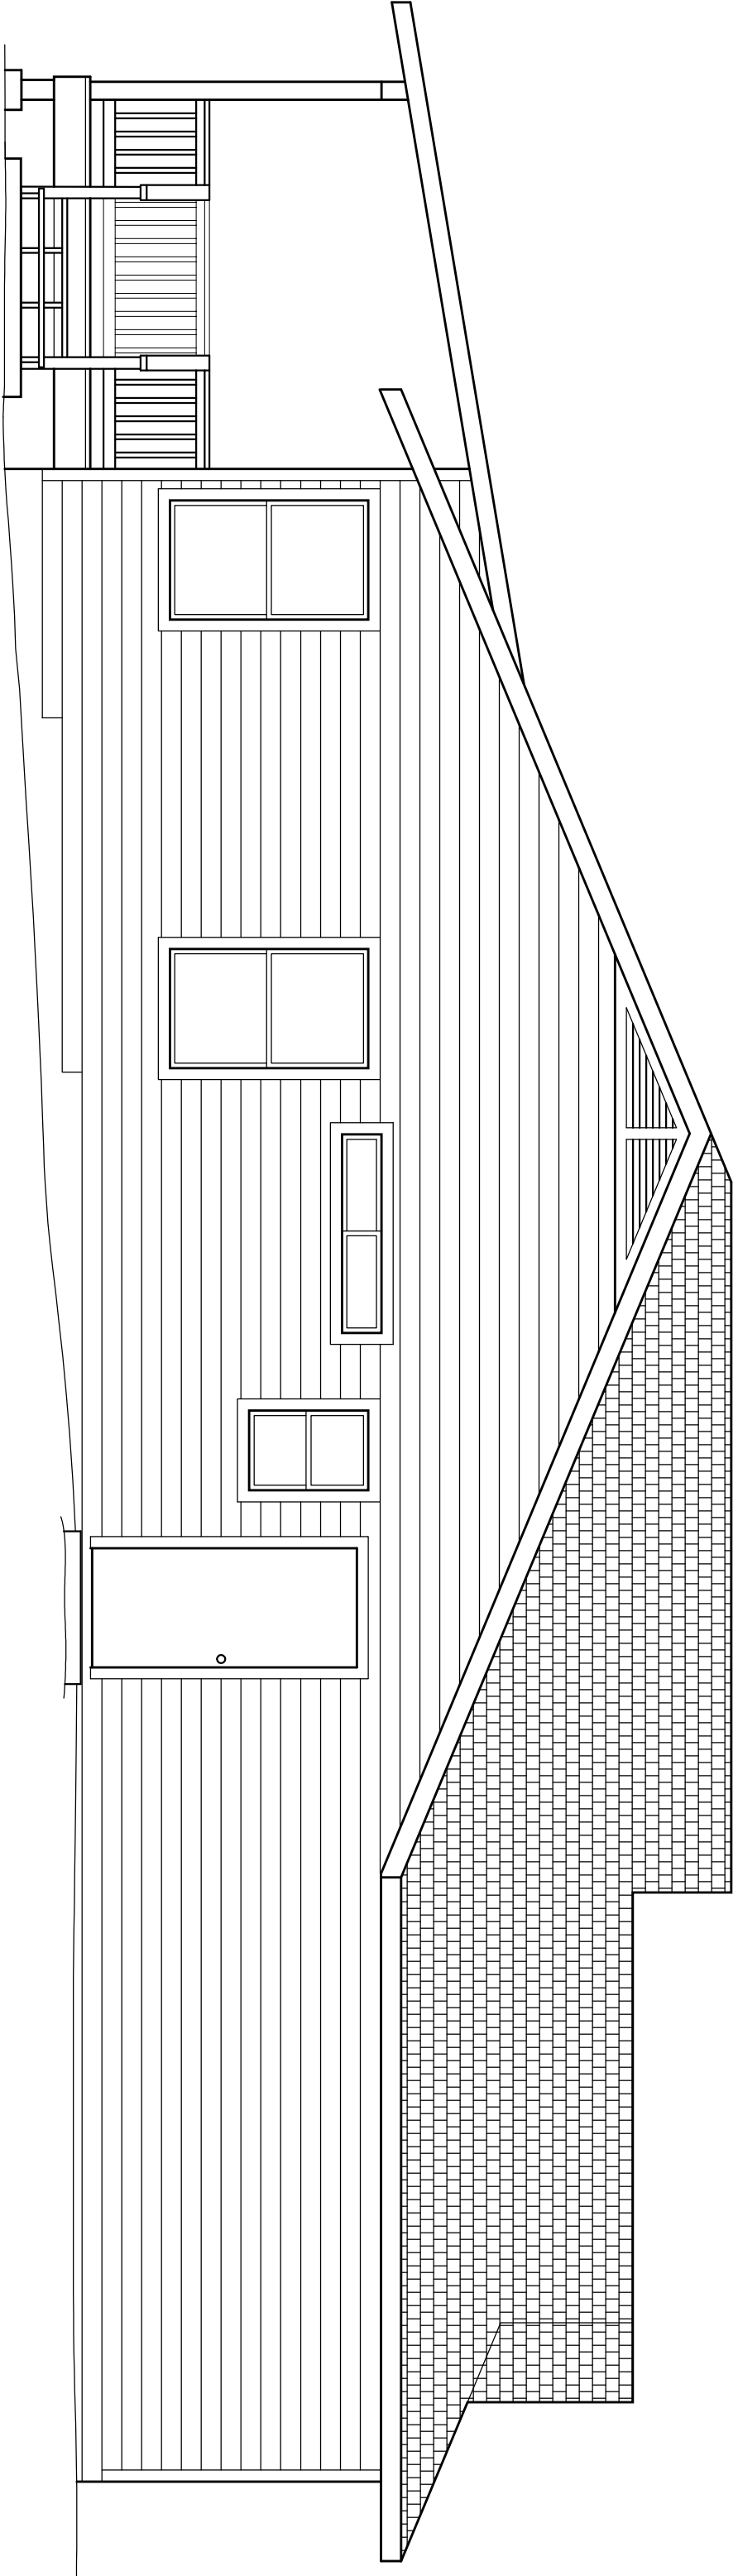

LEFT - SIDE ELEVATION

SCALE: 1/4" = 1'-0"

- GENERAL NOTES:
1. ADDRESS NUMBER TO BE VISIBLE & LEGIBLE FROM STREET.
 2. APPROVED PLANS & PERMIT CARDS TO BE ON JOB SITE UNTIL FINAL INSPECTION.
 3. DO NOT OCCUPY BEFORE FINAL INSPECTION.

Job no. :	02-001
Date :	1-25-02
Drawn by :	JVB
Chk'd by :	Noted
Scale :	22-03
Revised :	
Dwg. File :	Bishop-Scully.dwg

REVISIONS	BY
AS BUILT	JVB

BISHOP HOMES & CONSTRUCTION

928.474.6010 - PAYSON, ARIZONA 85541

SCULLY RESIDENCE
216 N. STAGECOACH PASS
PAYSON, AZ 85541

EXTERIOR ELEVATIONS

SHEET NO.:

AB

SHEET 3 OF 3